

AS-BUILT
RETAIL SINGLE STORY - VACANT SPACE

2211 WEST LINCOLN STREET,
HARLINGEN, TX 78552

CRUMBL - HARLINGEN
FOR




JZW ARCHITECTS

45 EAST CENTER STREET SUITE 202,
NORTH SALT LAKE, UTAH 84054



1 SITE LOCATION

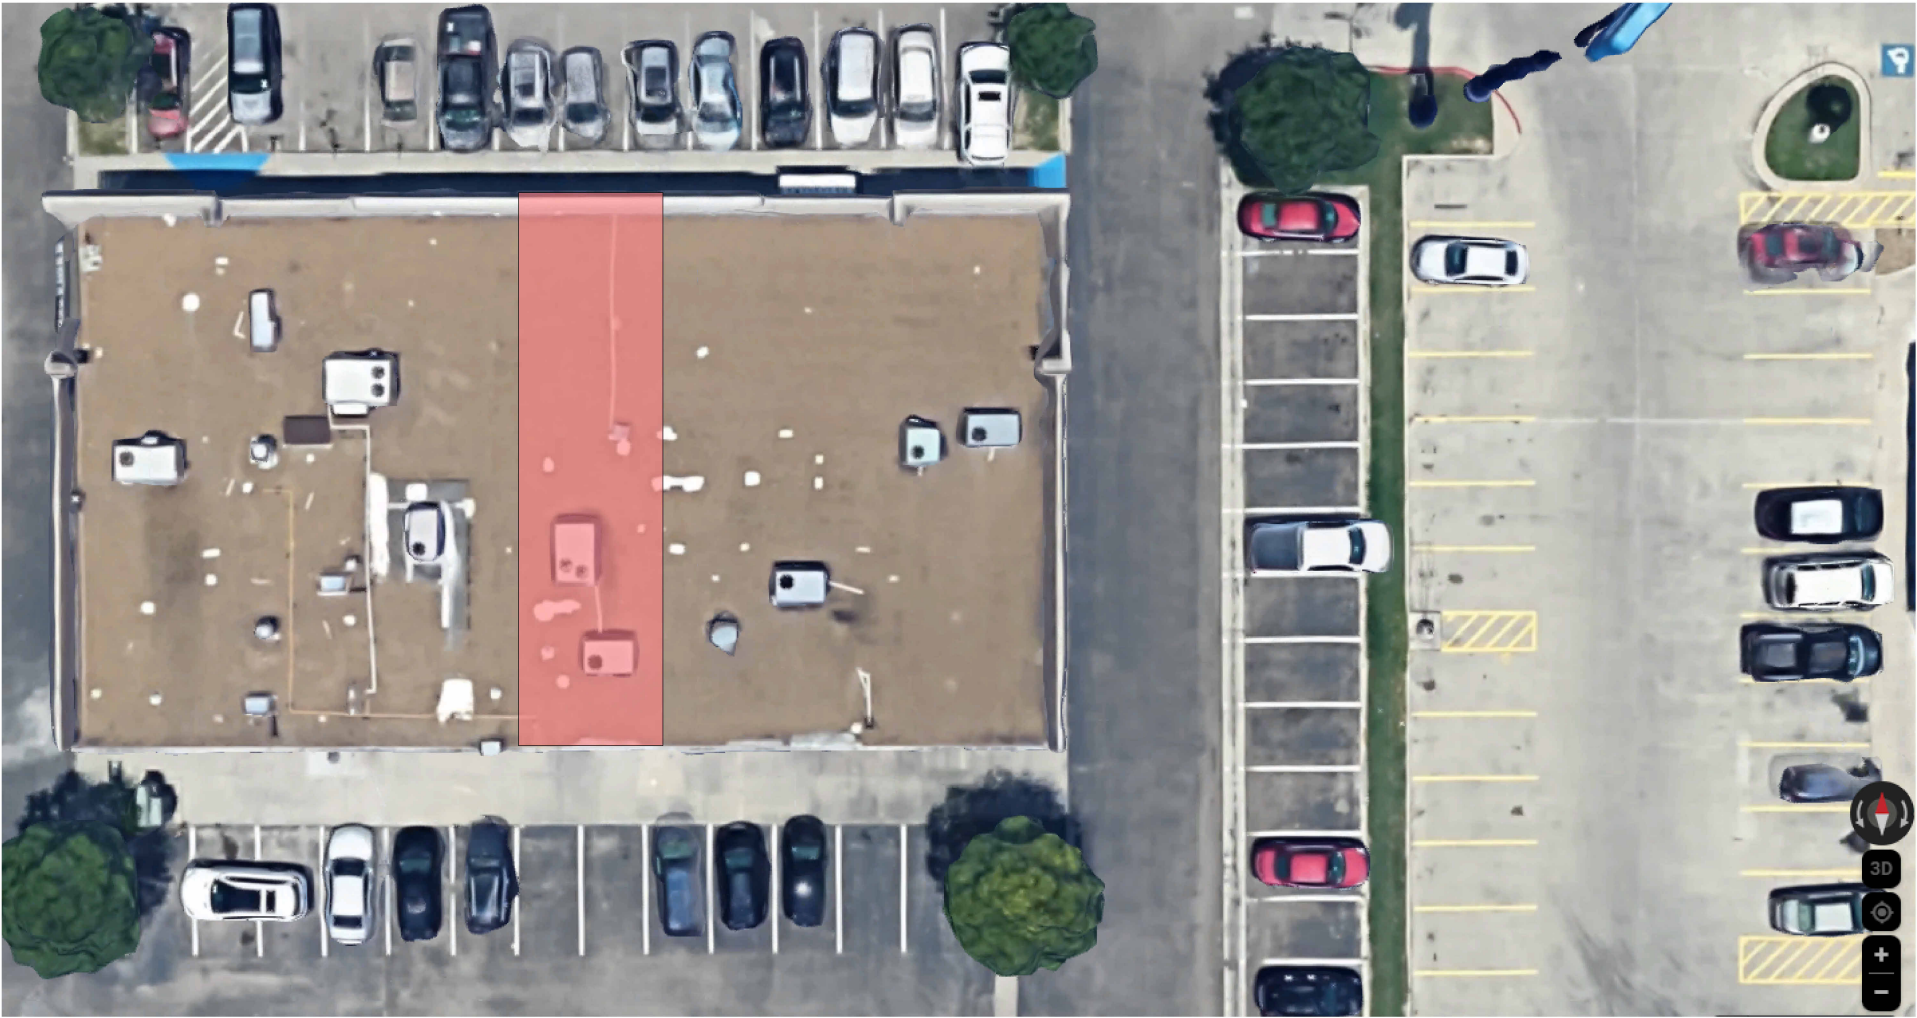

2 SPACE LOCATION

Sheet List	
Sheet #	Sheet Name
AB-000	COVER SHEET
AB-101	FLOOR, CEILING GRID, AND ROOF FRAMING LAYOUTS
AB-201	EXTERIOR ELEVATIONS AND BUILDING SECTIONS
AB-202	INTERIOR ELEVATIONS
AB-500	SITE PHOTOS (001-006)
AB-501	SITE PHOTOS (007-012)
AB-502	SITE PHOTOS (013-018)
AB-503	SITE PHOTOS (019-024)
AB-504	SITE PHOTOS (025-030)
AB-505	SITE PHOTOS (031-036)
AB-506	SITE PHOTOS (037-042)
AB-507	SITE PHOTOS (043-048)
AB-508	SITE PHOTOS (049-054)
AB-509	SITE PHOTOS (055-062)



PREMIER3D, LLC
REALITY CAPTURE - BIM - 2D drafting
139 Tonkawa Canyon Dr, La Marque, TX 7568
sales@premier3dscanning.com
www.premier3dscanning.com
Copyright © 2025

Premier3DScanningProject Number

AS-BUILT SURVEY
CRUMBL - HARLINGEN
2211 WEST LINCOLN STREET,
HARLINGEN, TX 78552

COVER SHEET

Revision Schedule

Revision #Revision DescriptionRevision Date


SHEET SIZE:

DRAWN BY:Author


SHEET:

AB-000


C:\s\Work\5 F3D\05-006 CumbilRevt 2025\Cumbil_R25.rvt 11/7/2025 7:29:04 AM

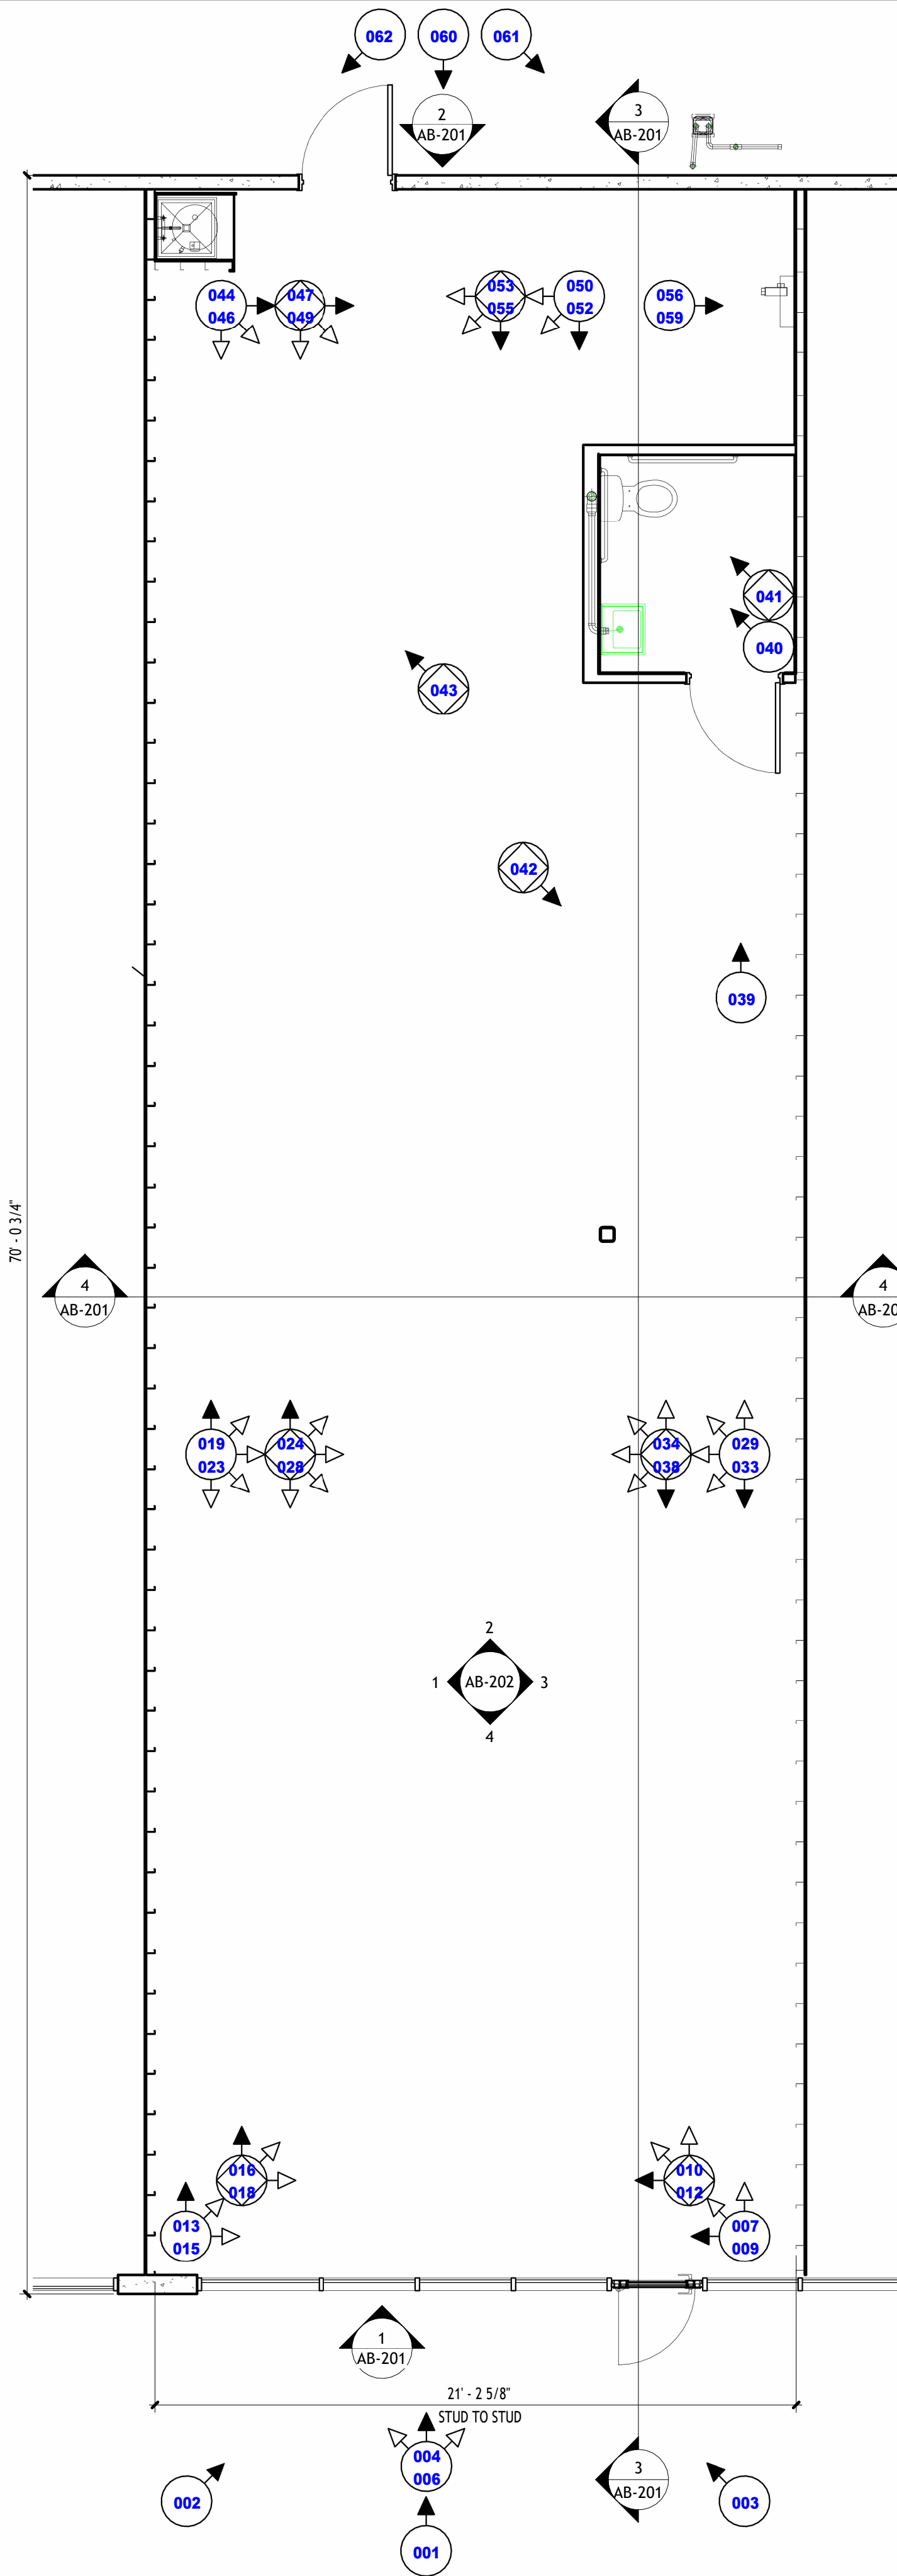


1 Level 1 - Floor Layout

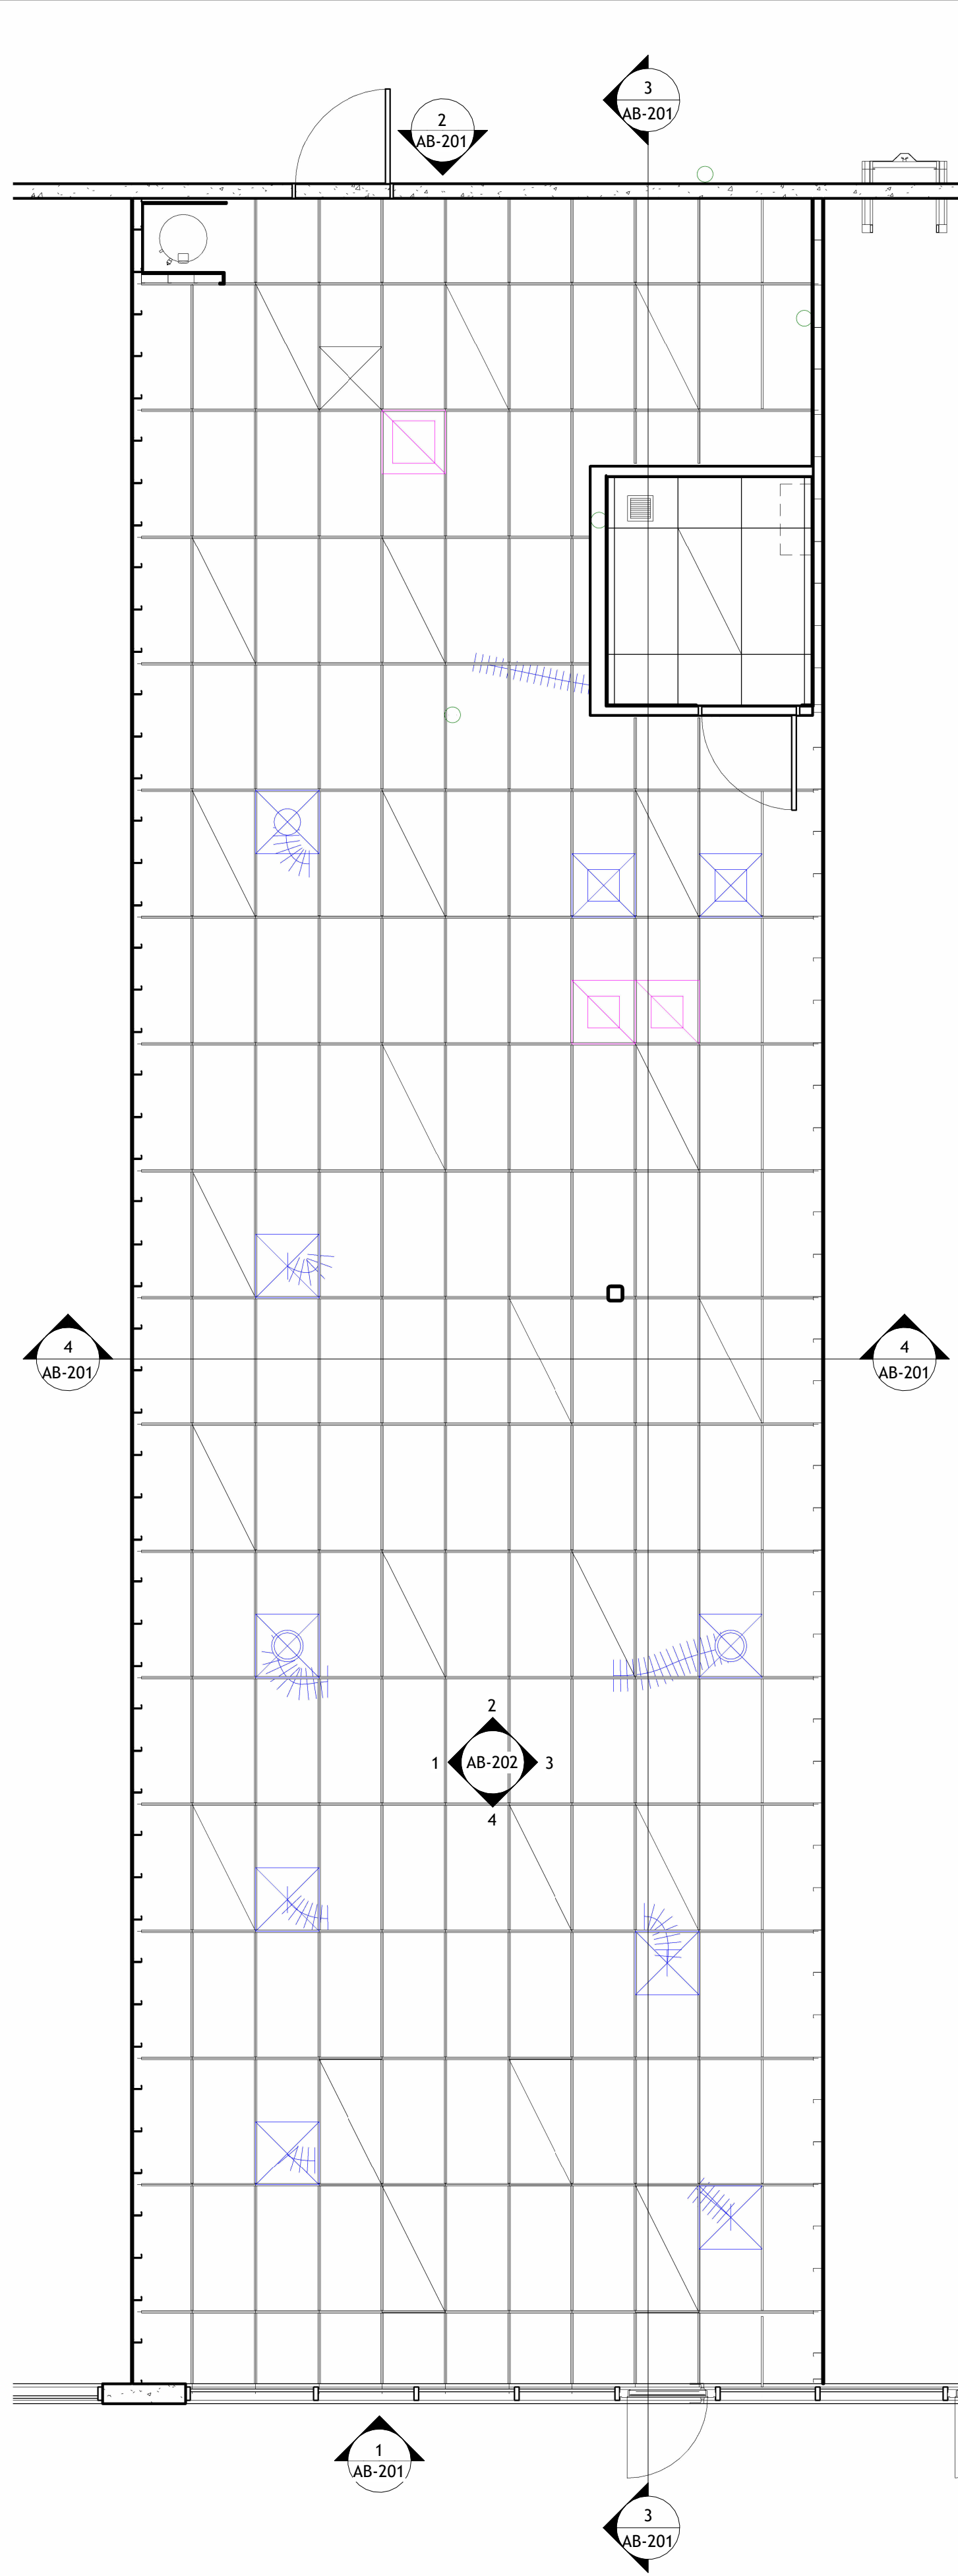

2 REFLECTED CEILING LAYOUT

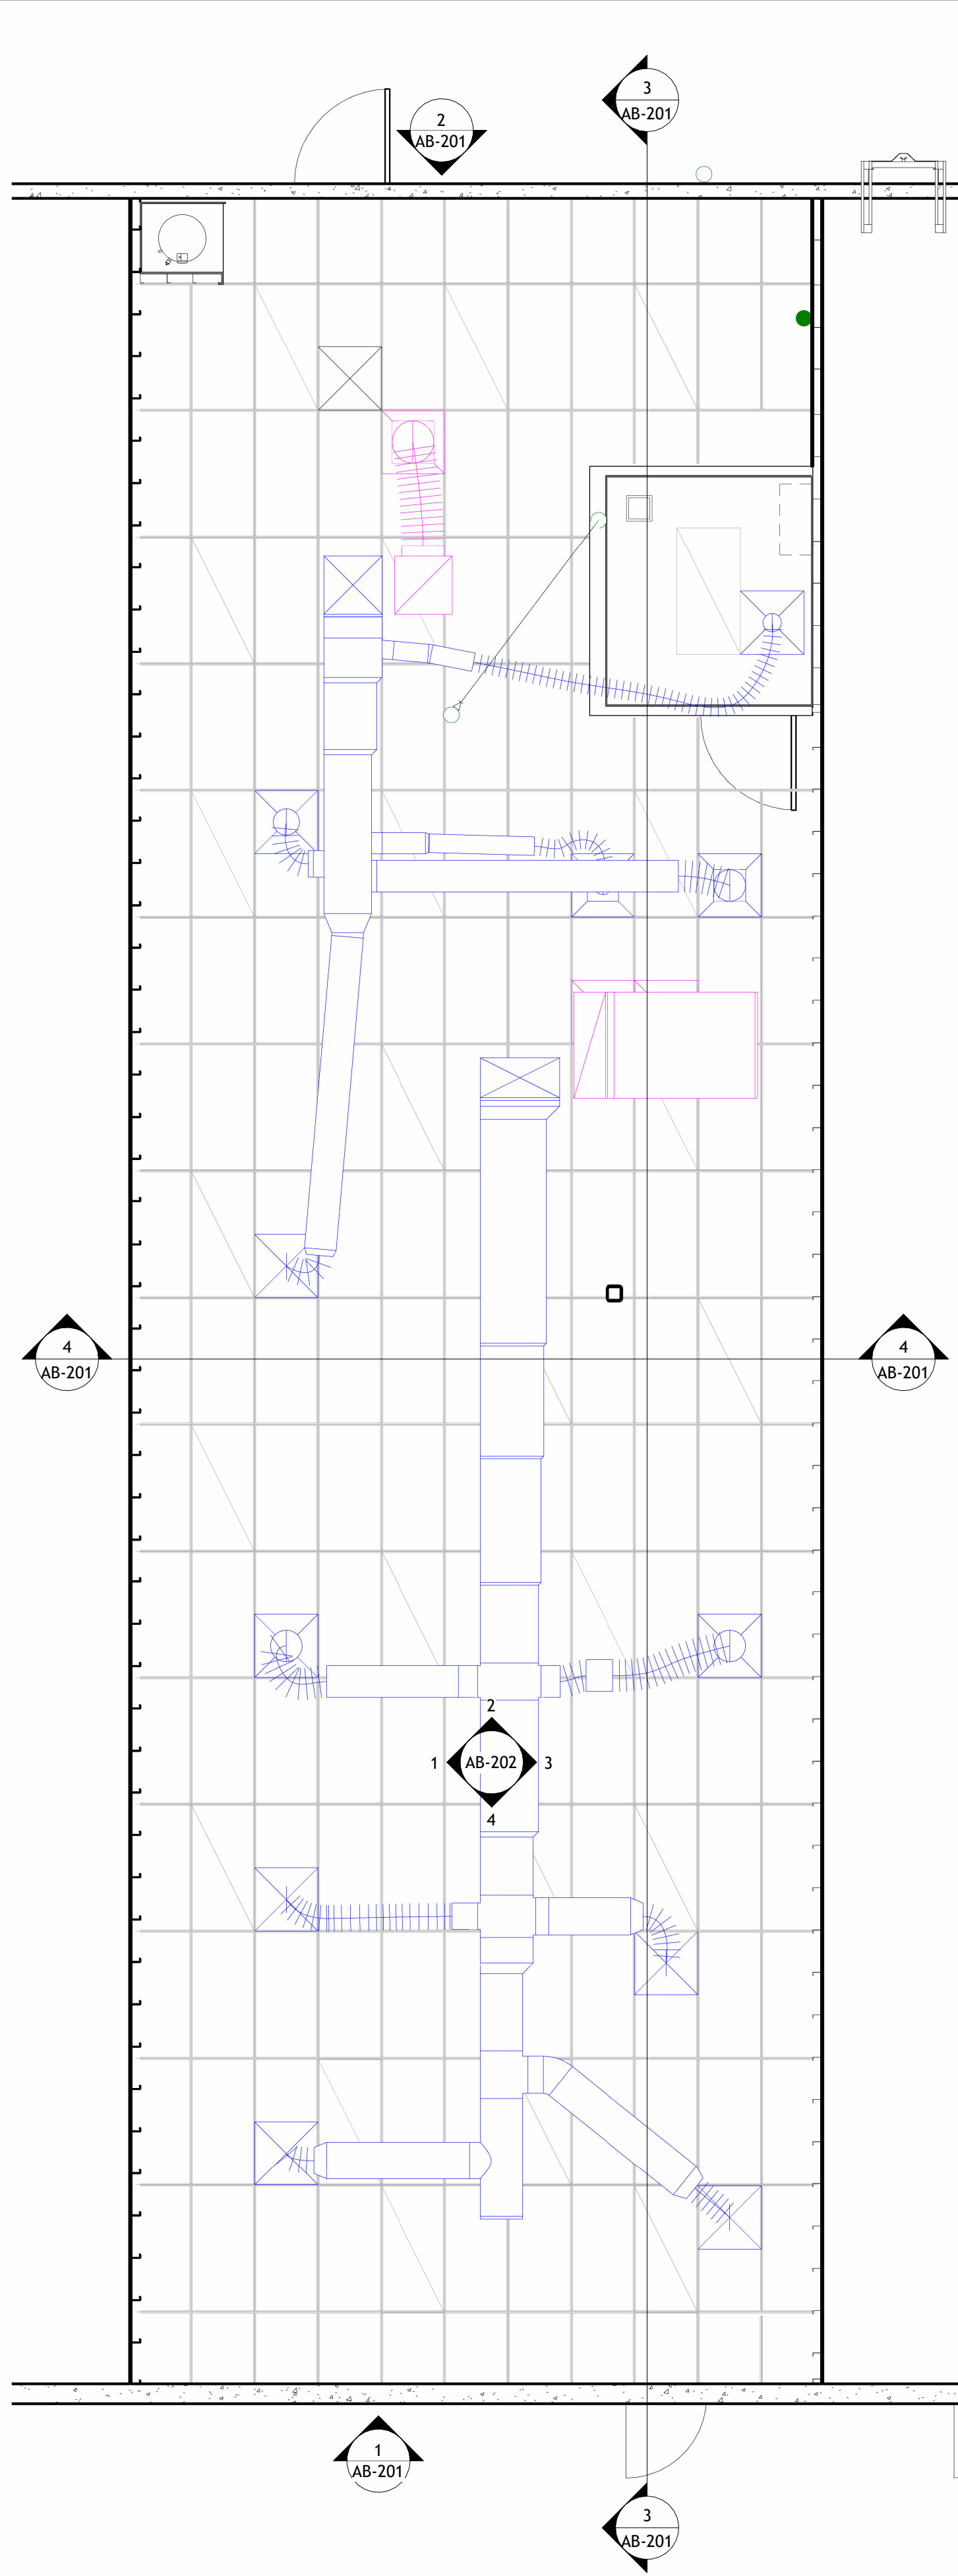

3 Level 3 - Floor Layout

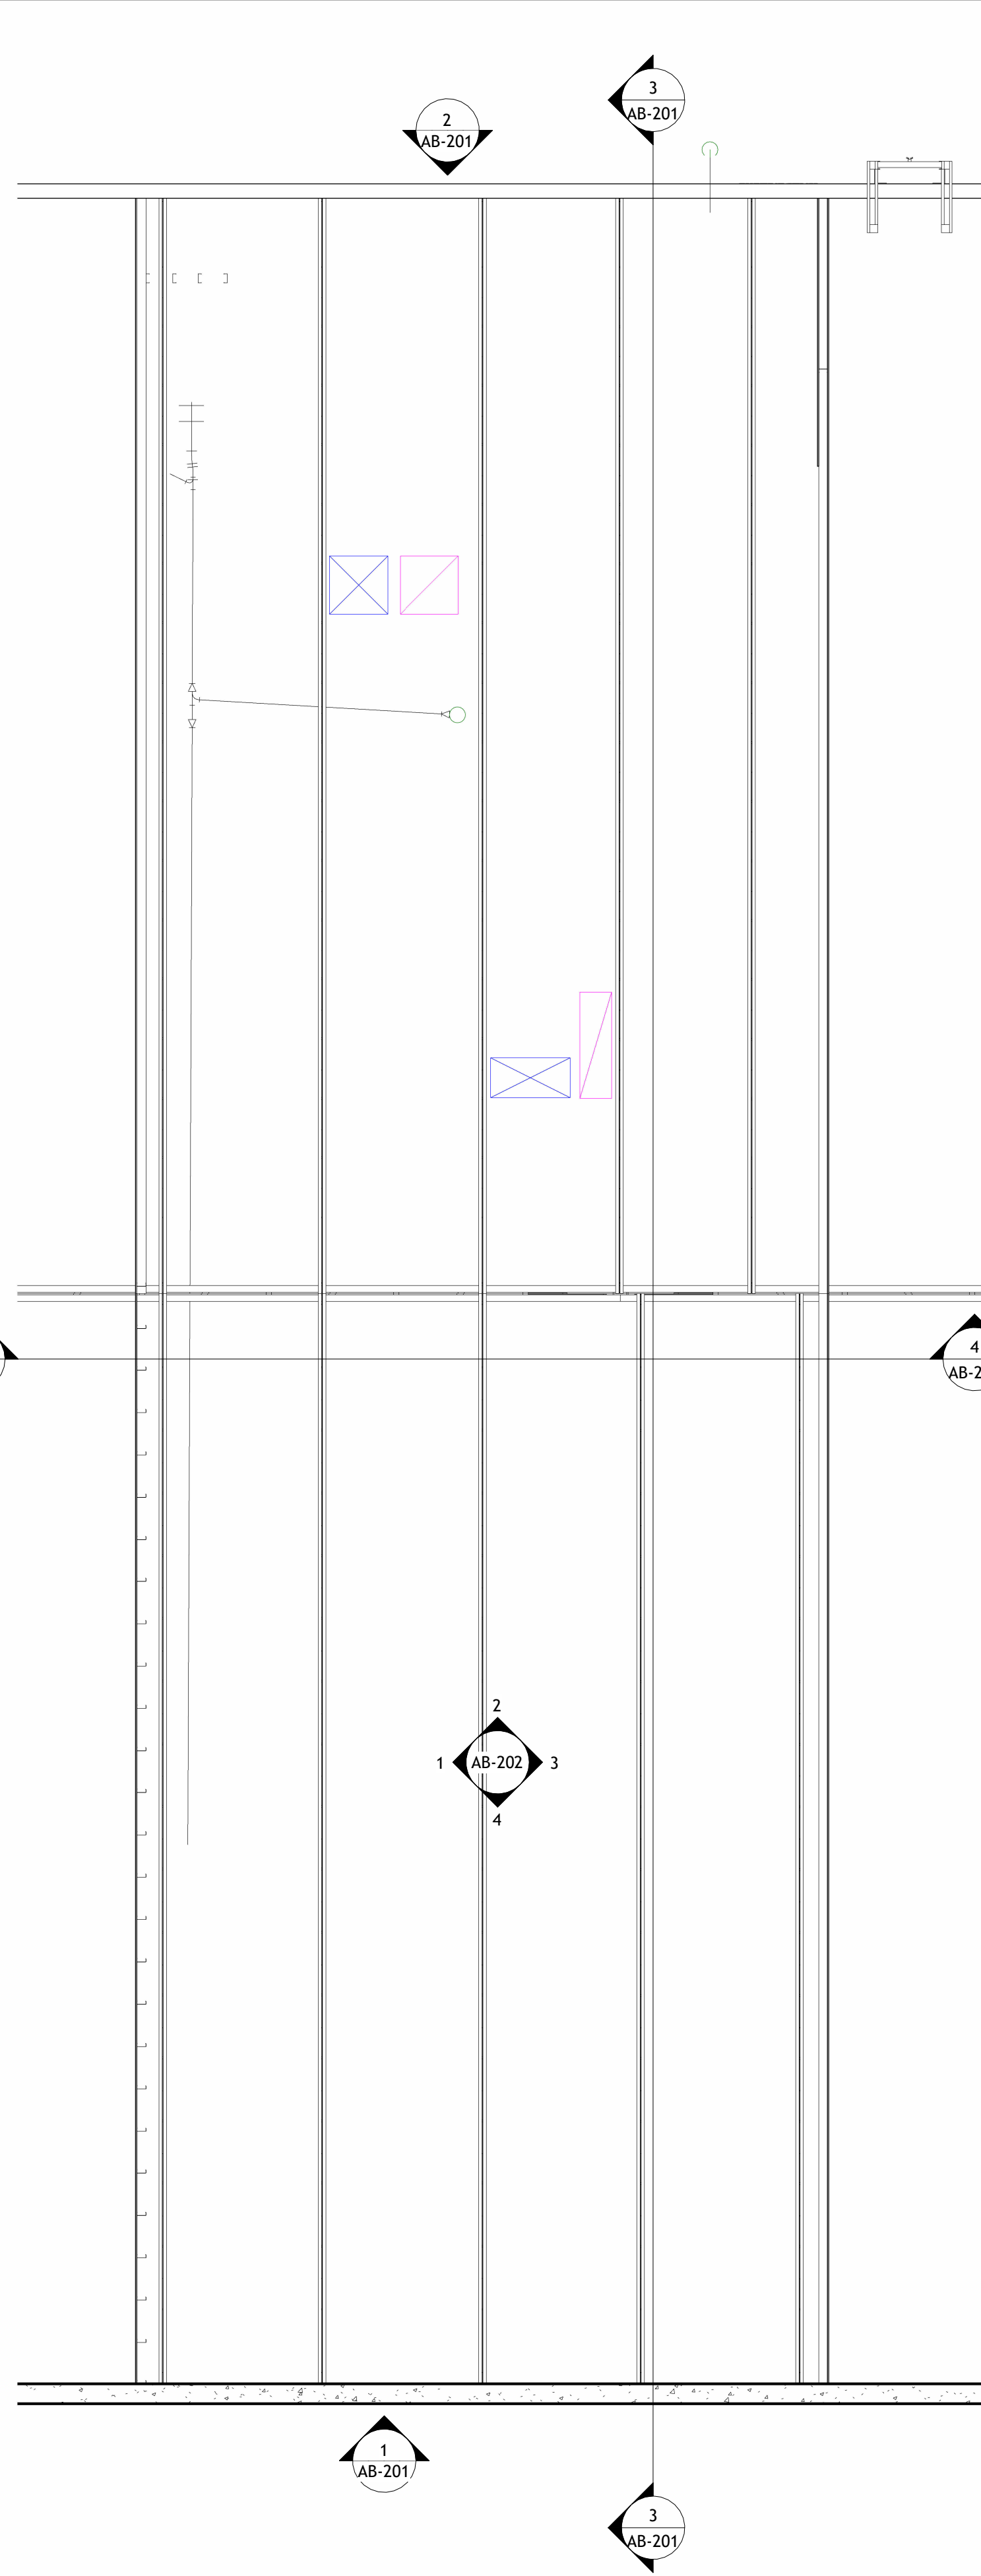

4 Level 3 - Floor Layout



PREMIER3D, LLC
REALITY CAPTURE - BIM - 2D drafting
139 Tonkawa Canyon Dr, La Marque, TX 75668
sales@premier3dscanning.com
www.premier3dscanning.com
Copyright © 2025

Premier3DScanning Project Number

AS-BUILT SURVEY
CRUMBL - HARLINGEN
2211 WEST LINCOLN STREET,
HARLINGEN, TX 78552

FLOOR, CEILING GRID, AND ROOF FRAMING LAYOUTS


Revision #	Revision Schedule	
	Revision Description	Revision Date

SHEET SIZE:


DRAWN BY: Author

SHEET:

AB-101

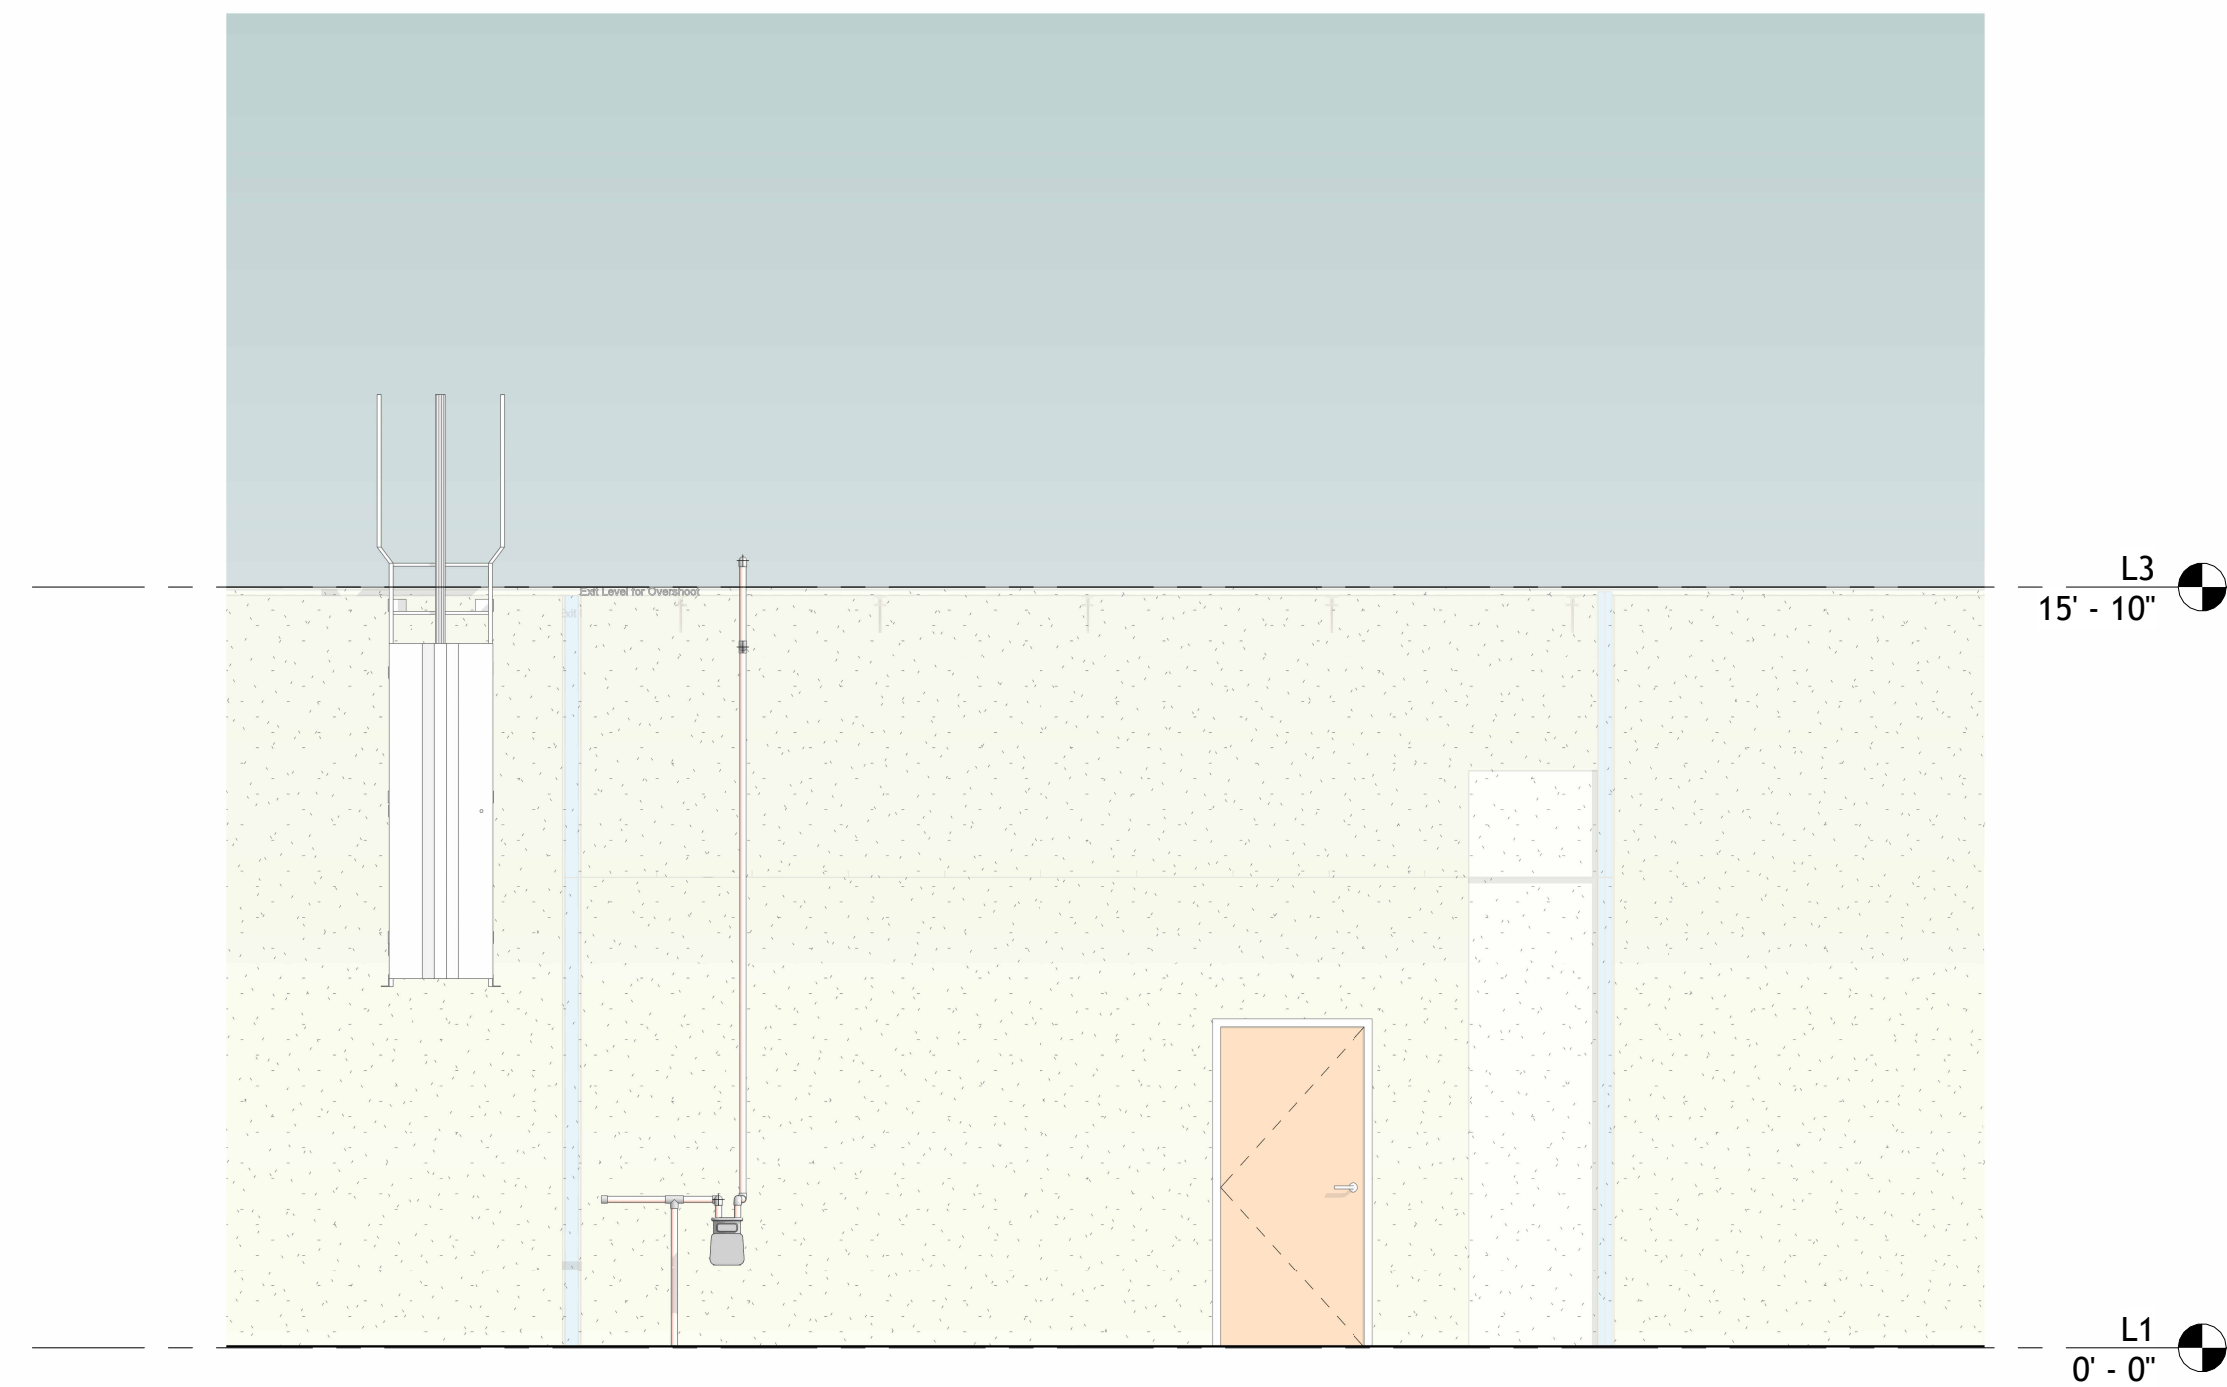

2 REAR EXTERIOR ELEVATION

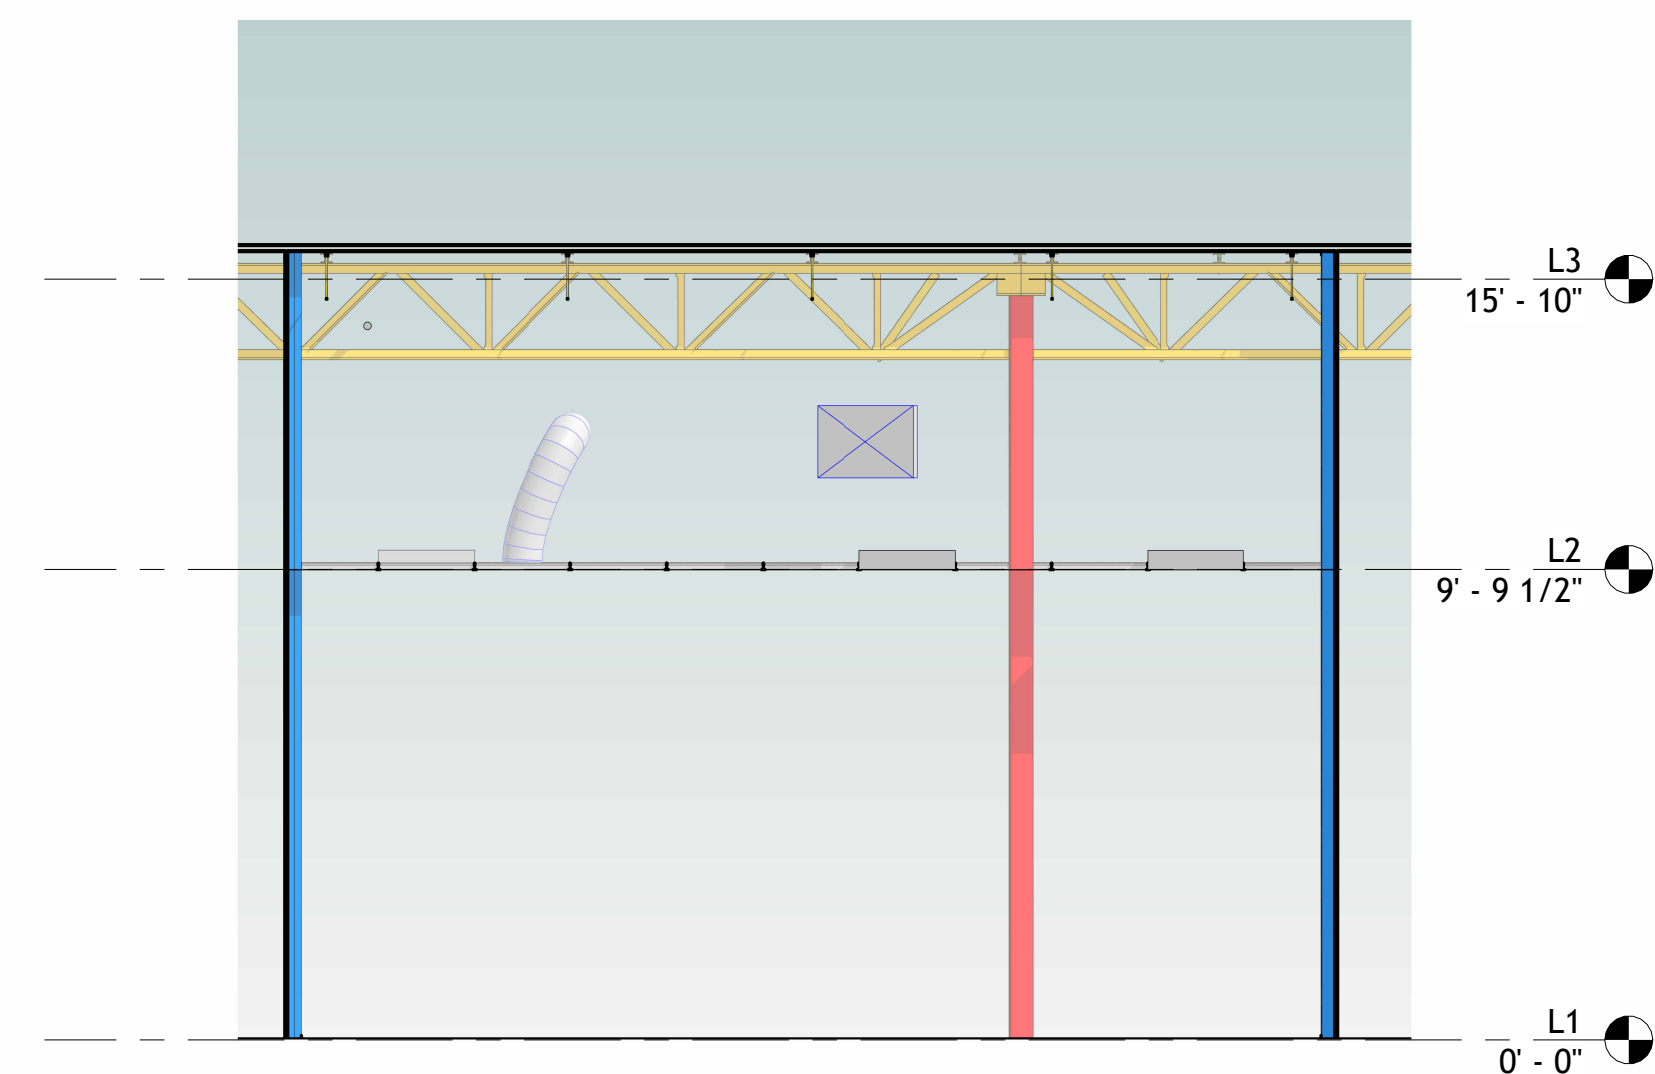

4 BUILDING CROSS SECTION

Revision Schedule		
Revision #	Revision Description	Revision Date

DRAWN BY:	Author
SHEET:	

AB-201



SHEET SIZE:	
DRAWN BY:	Author
SHEET:	

AS-BUILT SURVEY
CRUMBL - HARLINGEN
2211 WEST LINCOLN STREET,
HARLINGEN, TX 78552

INTERIOR ELEVATIONS

AB-202

1/17/2025 7:29:40 AM C:\\$ Work\3D\F3D025-006_CumblRevt 2025\Cumbl_R25.rvt



SITE PHOTO - 001



SITE PHOTO - 002



SITE PHOTO - 003



SITE PHOTO - 004



SITE PHOTO - 005



SITE PHOTO - 006



PREMIER3D, LLC
REALITY CAPTURE - BIM - 2D drafting
139 Tonkawa Canyon Dr, La Marque, TX 7568
sales@premier3dscanning.com
www.premier3dscanning.com
Copyright © 2025

Premier3DScanningProject Number

AS-BUILT SURVEY
CRUMBL - HARLINGEN
2211 WEST LINCOLN STREET,
HARLINGEN, TX 78552

SITE PHOTOS (001-006)

Revision #	Revision Schedule		Revision Date
	Revision Description		

SHEET SIZE:

DRAWN BY:Author

SHEET:**AB-500**



SITE PHOTO - 007



SITE PHOTO - 008



SITE PHOTO - 009



SITE PHOTO - 010



SITE PHOTO - 011



SITE PHOTO - 012



PREMIER3D, LLC
REALITY CAPTURE - BIM - 2D drafting
139 Tonkawa Canyon Dr, La Marque, TX 7568
sales@premier3dscanning.com
www.premier3dscanning.com
Copyright © 2025

Premier3DScanningProject Number

AS-BUILT SURVEY
CRUML - HARLINGEN
2211 WEST LINCOLN STREET,
HARLINGEN, TX 78552

SITE PHOTOS (007-012)

Revision #	Revision Schedule		Revision Date
	Revision Description		

SHEET SIZE:

DRAWN BY:Author

SHEET:**AB-501**



SITE PHOTO - 013



SITE PHOTO - 014



SITE PHOTO - 015



SITE PHOTO - 016



SITE PHOTO - 017



SITE PHOTO - 018



PREMIER3D, LLC
REALITY CAPTURE - BIM - 2D drafting
139 Tonkawa Canyon Dr, La Marque, TX 7568
sales@premier3dscanning.com
www.premier3dscanning.com
Copyright © 2025

Premier3DScanningProject Number

AS-BUILT SURVEY
CRUMBL - HARLINGEN
2211 WEST LINCOLN STREET,
HARLINGEN, TX 78552

SITE PHOTOS (013-018)

Revision #	Revision Schedule		Revision Date
	Revision Description		

SHEET SIZE:

DRAWN BY:Author

SHEET:**AB-502**



SITE PHOTO - 019



SITE PHOTO - 020



SITE PHOTO - 021



SITE PHOTO - 022



SITE PHOTO - 023



SITE PHOTO - 024



PREMIER3D, LLC
REALITY CAPTURE - BIM - 2D drafting
139 Tonkawa Canyon Dr, La Marque, TX 75668
sales@premier3dscanning.com
www.premier3dscanning.com
Copyright © 2025

Premier3DScanningProject Number

AS-BUILT SURVEY
CRUMBL - HARLINGEN
2211 WEST LINCOLN STREET,
HARLINGEN, TX 78552

SITE PHOTOS (019-024)

Revision #	Revision Schedule	
	Revision Description	Revision Date

SHEET SIZE:

DRAWN BY:Author

SHEET:**AB-503**



SITE PHOTO - 025



SITE PHOTO - 026



SITE PHOTO - 027



SITE PHOTO - 028



SITE PHOTO - 029



SITE PHOTO - 030



PREMIER3D, LLC
REALITY CAPTURE - BIM - 2D drafting
139 Tonkawa Canyon Dr, La Marque, TX 75668
sales@premier3dscanning.com
www.premier3dscanning.com
Copyright © 2025

Premier3DScanningProject Number

AS-BUILT SURVEY
CRUMBL - HARLINGEN
2211 WEST LINCOLN STREET,
HARLINGEN, TX 78552

SITE PHOTOS (025-030)

Revision #	Revision Schedule	
	Revision Description	Revision Date

SHEET SIZE:

DRAWN BY:Author

SHEET:**AB-504**



SITE PHOTO - 031



SITE PHOTO - 032



SITE PHOTO - 033



SITE PHOTO - 034



SITE PHOTO - 035



SITE PHOTO - 036



PREMIER3D, LLC
REALITY CAPTURE - BIM - 2D drafting
139 Tonkawa Canyon Dr, La Marque, TX 7568
sales@premier3dscanning.com
www.premier3dscanning.com
Copyright © 2025

Premier3DScanningProject Number

AS-BUILT SURVEY
CRUMBL - HARLINGEN
2211 WEST LINCOLN STREET,
HARLINGEN, TX 78552

SITE PHOTOS (031-036)

Revision #	Revision Schedule		Revision Date
	Revision Description		

SHEET SIZE:

DRAWN BY:Author

SHEET:**AB-505**



SITE PHOTO - 037



SITE PHOTO - 038



SITE PHOTO - 039



SITE PHOTO - 040



SITE PHOTO - 041



SITE PHOTO - 042



PREMIER3D, LLC
REALITY CAPTURE - BIM - 2D drafting
139 Tonkawa Canyon Dr, La Marque, TX 7568
sales@premier3dscanning.com
www.premier3dscanning.com
Copyright © 2025

Premier3DScanningProject Number

AS-BUILT SURVEY
CRUMBL - HARLINGEN
2211 WEST LINCOLN STREET,
HARLINGEN, TX 78552

SITE PHOTOS (037-042)

Revision #	Revision Schedule		Revision Date
	Revision Description		

SHEET SIZE:

DRAWN BY:Author

SHEET:

AB-506



SITE PHOTO - 043



SITE PHOTO - 044



SITE PHOTO - 045



SITE PHOTO - 047



SITE PHOTO - 048



SITE PHOTO - 049



PREMIER3D, LLC
REALITY CAPTURE - BIM - 2D drafting
139 Tonkawa Canyon Dr, La Marque, TX 7568
sales@premier3dscanning.com
www.premier3dscanning.com
Copyright © 2025

Premier3DScanningProject Number

AS-BUILT SURVEY
CRUMBL - HARLINGEN
2211 WEST LINCOLN STREET,
HARLINGEN, TX 78552

SITE PHOTOS (043-048)

Revision #	Revision Schedule		Revision Date
	Revision Description		

SHEET SIZE:

DRAWN BY:Author

SHEET:**AB-507**



SITE PHOTO - 049



SITE PHOTO - 050



SITE PHOTO - 051



SITE PHOTO - 052



SITE PHOTO - 053



SITE PHOTO - 054



PREMIER3D, LLC
REALITY CAPTURE - BIM - 2D drafting
139 Tonkawa Canyon Dr, La Marque, TX 75668
sales@premier3dscanning.com
www.premier3dscanning.com
Copyright © 2025

Premier3DScanningProject Number

AS-BUILT SURVEY
CRUMBL - HARLINGEN
2211 WEST LINCOLN STREET,
HARLINGEN, TX 78552

SITE PHOTOS (049-054)

Revision #	Revision Schedule		Revision Date
	Revision Description		

SHEET SIZE:

DRAWN BY:Author

SHEET:**AB-508**

Premier3DScanning Project Number

AS-BUILT SURVEY
CRUMBL - HARLINGEN
2211 WEST LINCOLN STREET,
HARLINGEN, TX 78552

SITE PHOTOS (055-062)

Revision Schedule		
Revision #	Revision Description	Revision Date

SHEET SIZE:

DRAWN BY:	Author
SHEET:	

AB-509